




Elevations

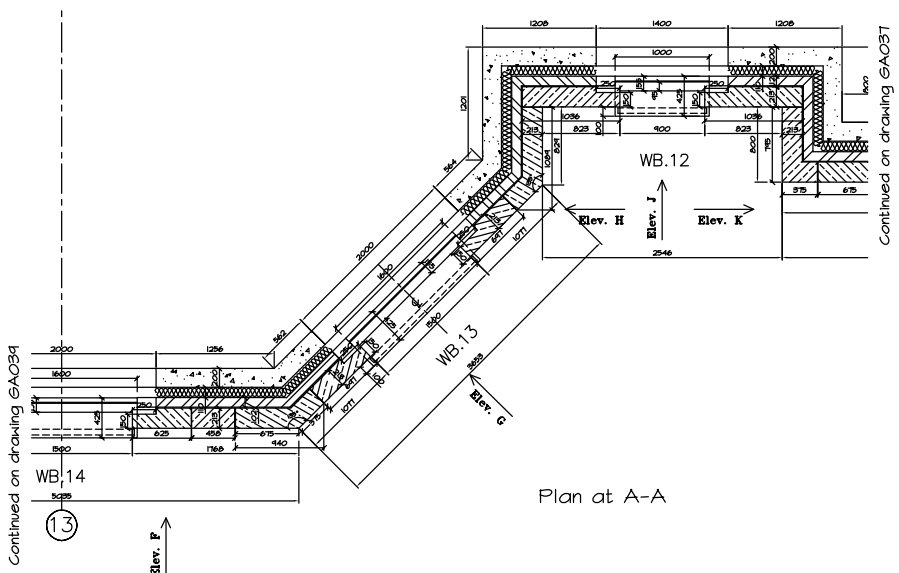

Plan at A-A

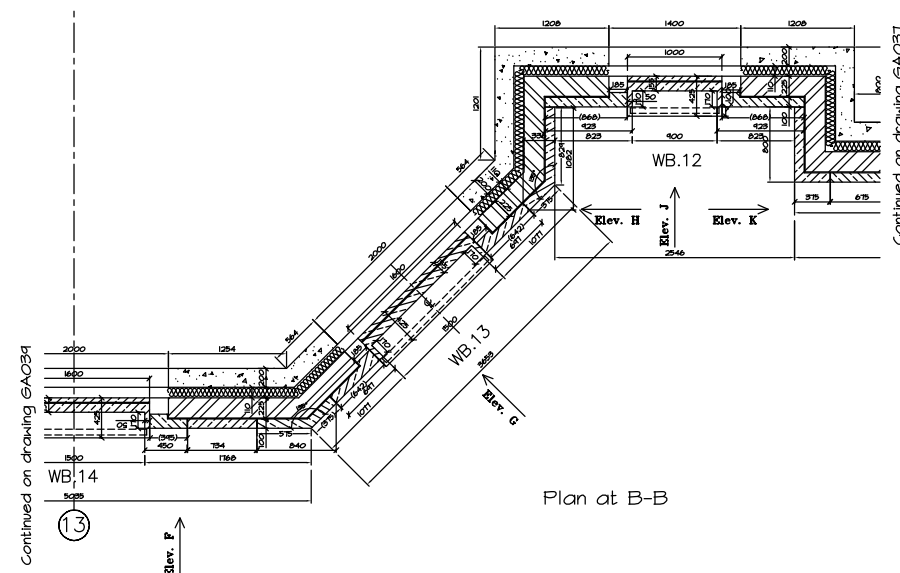


Plan at B-B

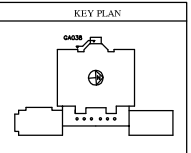

NOTE:
ALL FIXINGS TO BE STAINLESS STEEL
UNLESS STATED OTHERWISE
DWGS TO BE READ IN CONJUNCTION
WITH ARCHITECT'S DWGS.

JJ Joggle Joint
All stone beds and joints to be 5mm

Dimension styles:
40 Gross overall sizes including joints.
40 Net stone sizes

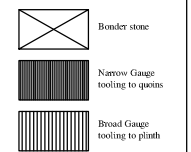

Mortar Mix: To be as specification
Stone type: MASSANGIS

DRAWING BY
S

stewart design (uk) limited
Tel: + 44 (0) 1608 811500 Fax: + 44 (0) 1608 811700
e-mail: design@stewartdesign.co.uk
web site: www.stewartdesign.co.uk

REV	DATE	AMENDMENT
C	31.03.03	AS BUILT ISSUE Revision to accommodate window head detail.
B	26.7.02	Detail revised to accommodate ash windows. Coping fixing details amended Brickwork piers revised to Architects comments Stone numbers added
A	22.10.01	Updated as per returned and marked up dwgs - coping dip added, modification layout amended, fixings added. Cill depth on plan amended. Joining on plan added.

DRAWING STATUS BOX	
<input type="checkbox"/>	Am Approved
<input type="checkbox"/>	B= Approved subject to comments
<input type="checkbox"/>	C= Revise drawing to comments and reissue:

(Status to be completed by Architect before return)

ISSUED FOR	
<input checked="" type="checkbox"/>	As Built
<input type="checkbox"/>	Information
<input type="checkbox"/>	Site

COPYRIGHT
Not to be reproduced without written permission

PROJECT
Tusmore House

DRAWING TITLE
General arrangement
West elevation bathroom floor
Gridlines 11-13
Elevation, section and plan

APS Masonry
AXTELL PERRY SYMM MASONRY LIMITED
OSNEY MEAD, OXFORD, OX2 0EQ
TEL: 01865 254600
FAX: 01865 254617
E-mail: Richard@APSMasonry.com

DRAWN BY	NSH	DATE	21/08/01
SCALE	1:20 @ A0	DRAWING No.	XO50
DATE	21/08/01	PROJECT	GA038
DRAWING No.	XO50	REV	C